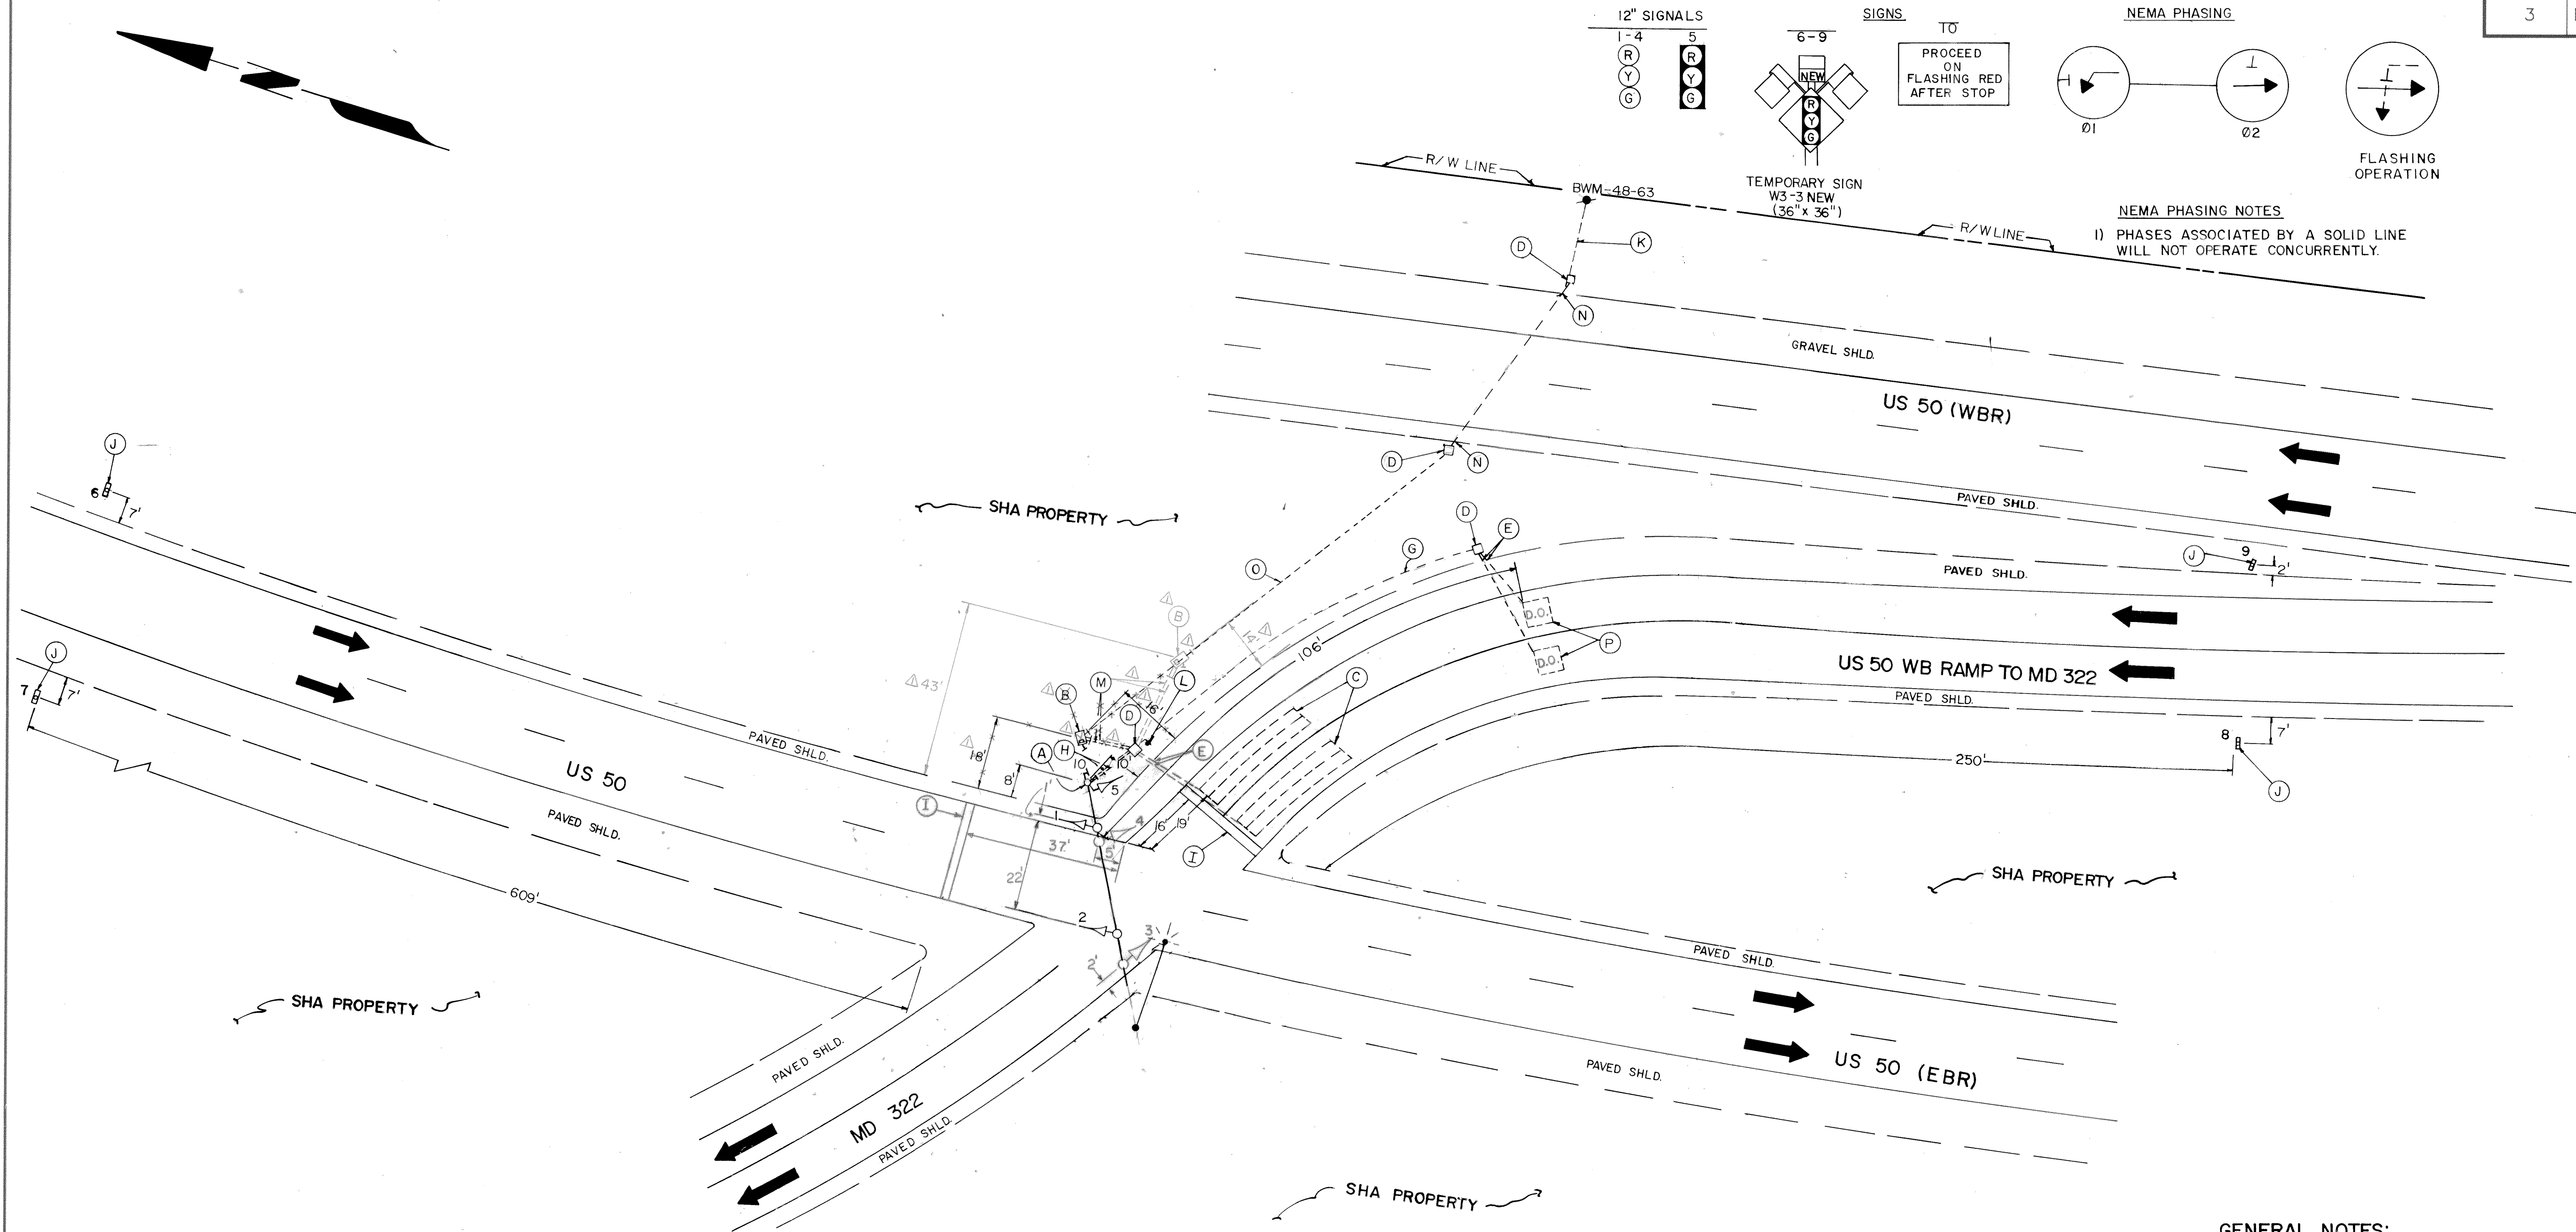

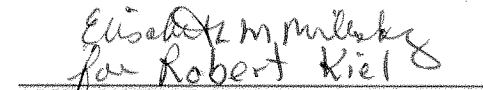





| F H WA REGION NO | STATE | FED. AID PROJ. NO | SHEET NO. | TOTAL SHEETS |
|---------------------|-------|----------------------|--------------|-----------------|
| 3 | MD. | | | |



| LEGEND OF UNDERGROUND AND OVERHEAD UTILITIES | | | | |
|--|------|-----|-----|----|
| AERIAL CABLE | —A— | A— | A— | A |
| ELECTRIC | —E— | E— | E— | E |
| TELEPHONE | —T— | T— | T— | T |
| GAS | —G— | G— | G— | G |
| SEWER | —S— | S— | S— | S |
| WATER | —W— | W— | W— | W |
| CABLE TV | —TV— | TV— | TV— | TV |

JOHNSON, MIRMIRAN & THOMPSON, P. A.
810 GLENEAGLES CT.
BALTIMORE, MARYLAND

| REVISIONS | APPROVALS |
|--|--|
| | <div>  for: Robert A. Zefrin CHIEF, SIGNAL DESIGN SECTION </div> <div>  for: Robert Kiel ASSTV DISTRICT ENGINEER, TRAFFIC </div> <div>  CHIEF, BUREAU OF TRAFFIC ENGINEERING </div> <div>  DEPUTY CHIEF ENGINEER, OFFICE OF TRAFFIC </div> |
| RED LINE REVISION #1 5/1/90 Relocate Controller and Rewire | |

| | | | |
|---|--------------------------------|--|------------------------|
| MARYLAND DEPARTMENT OF TRANSPORTATION STATE HIGHWAY ADMINISTRATION — OFFICE OF TRAFFIC TRAFFIC ENGINEERING DIVISION | | | |
| DRAWN BY: T. SPECA (FOR JMT) | DES. BY: M. ELAAOUAR (FOR JMT) | CHK. BY:  | SIGNAL NO. 20005013.97 |
| DATE: 10/13/89 | F.A.P. NO. | S.H.A. NO. | TS/FILE NO. 2590 |
| SCALE: 1" = 20' | | | SHEET NO. OF |

20005013.97